


FIRE FIGHTING ACCESS PLAN

FIRE HYDRANTS

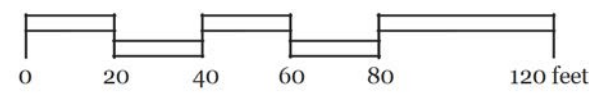


LOT 22 ~ UBC SOUTH CAMPUS
FIRE DEPARTMENT ACCESS


Jan 4, 2013 - Development Permit Submission Sk-9.01




UBC Properties Trust

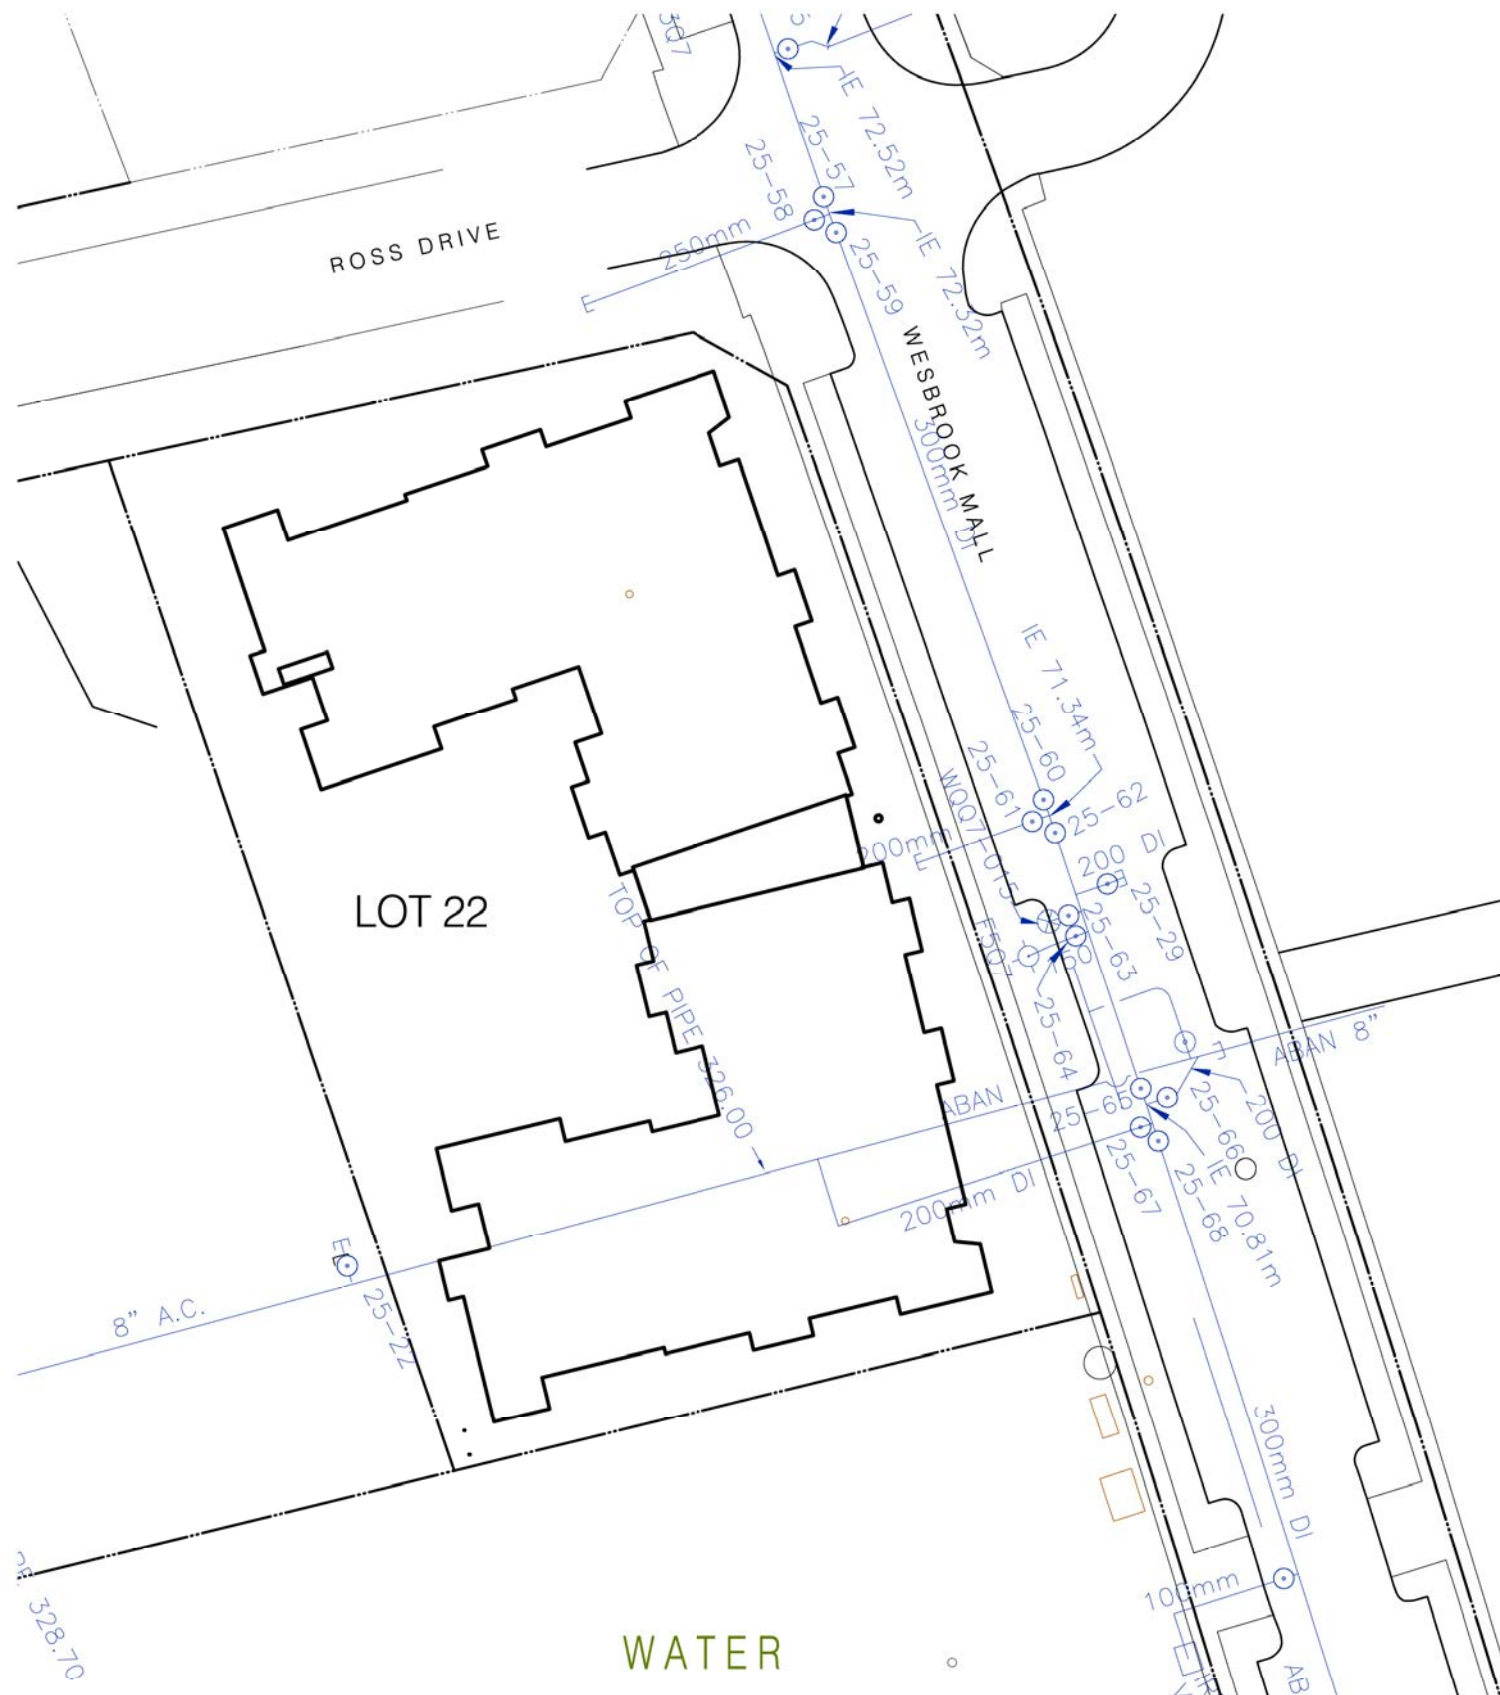

WATER

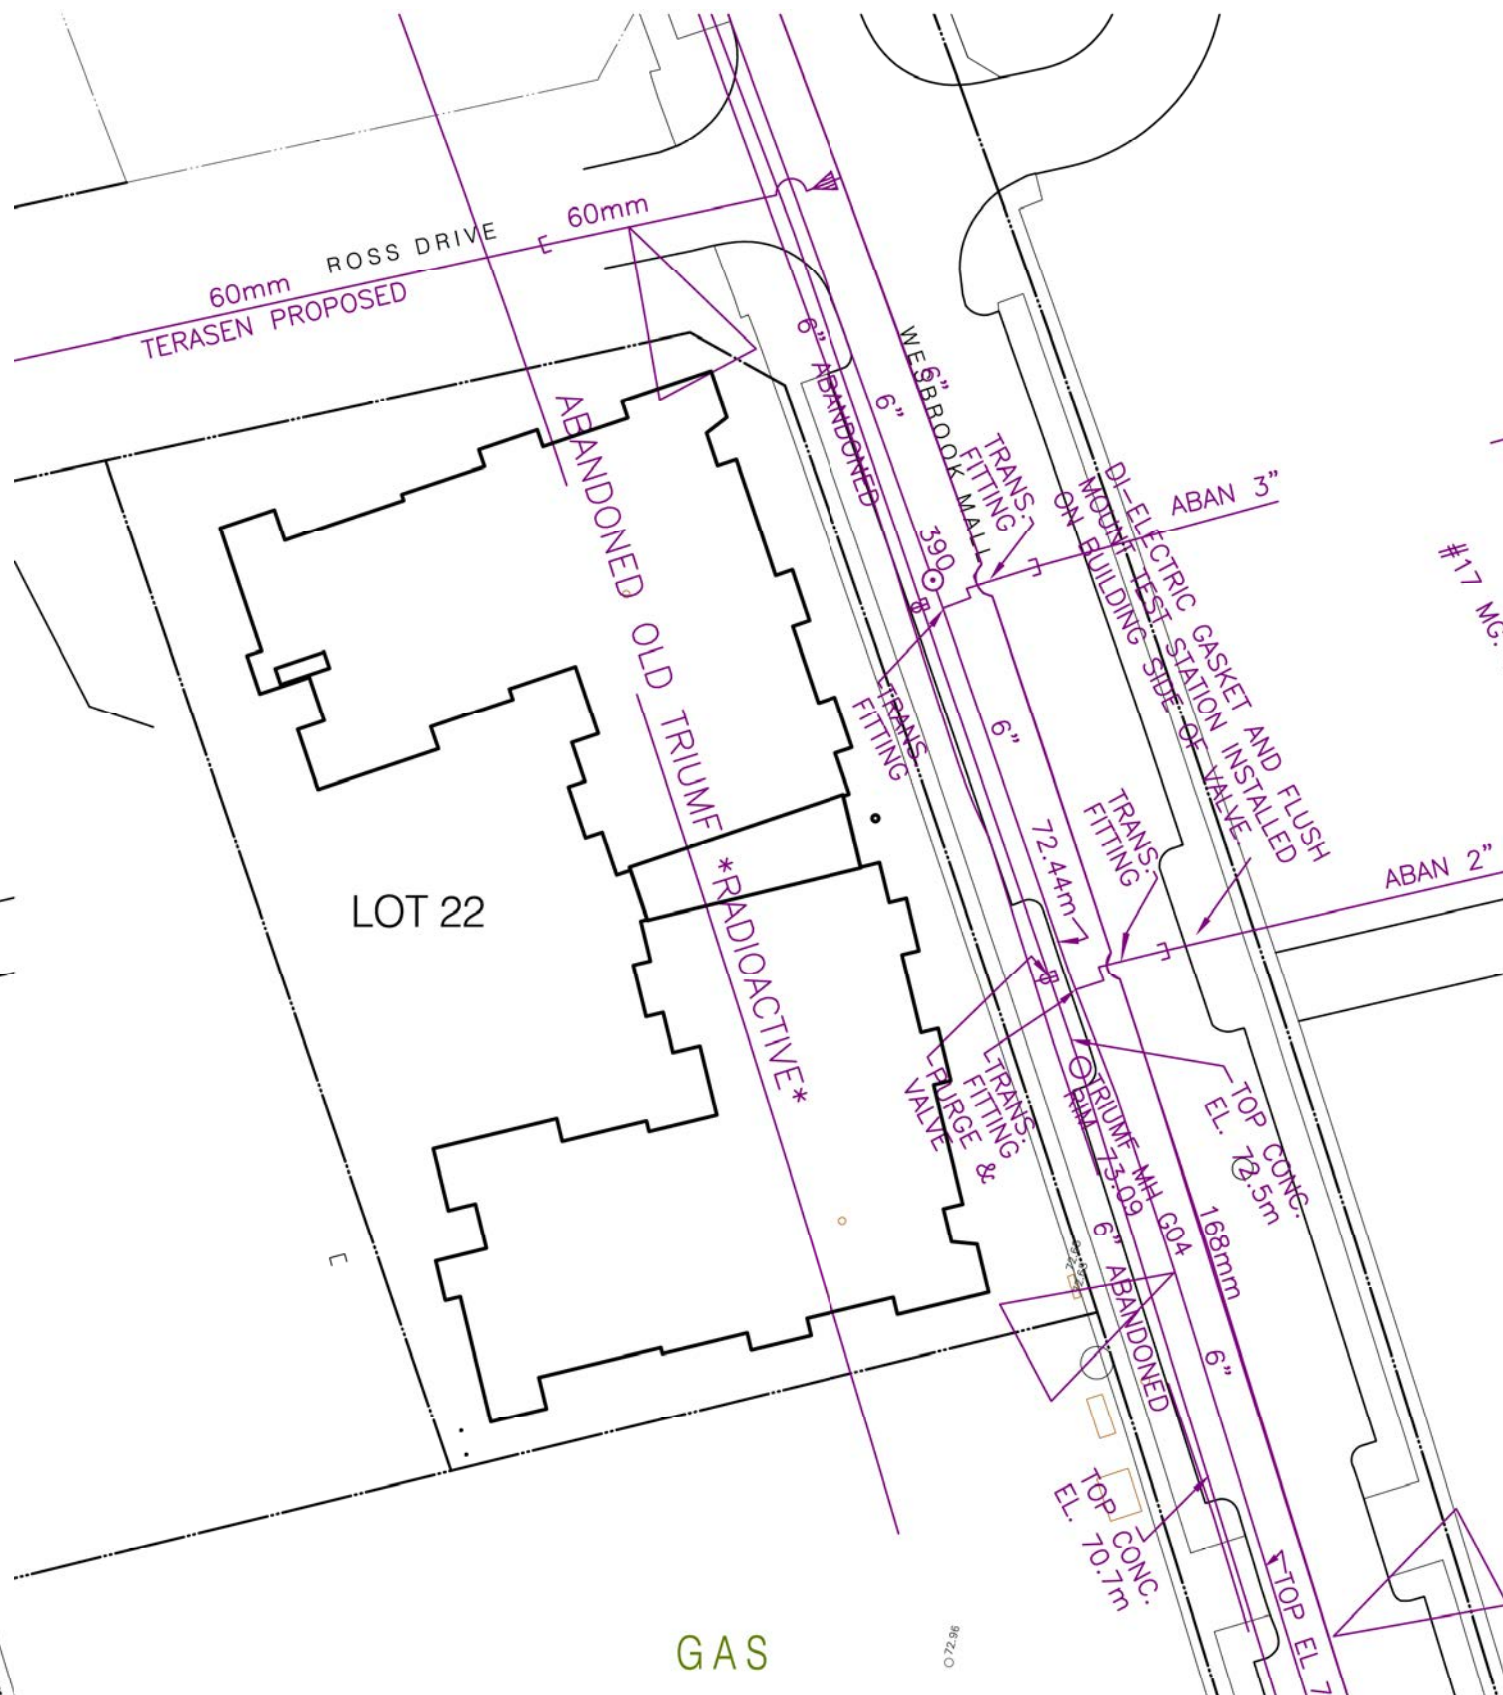

GAS

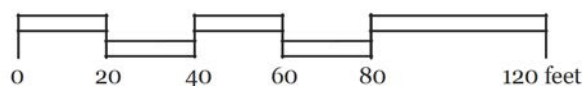


LOT 22 ~ UBC SOUTH CAMPUS UTILITIES RECORD PLANS


Jan 4, 2013 - Development Permit Submission Sk-9.02




UBC Properties Trust

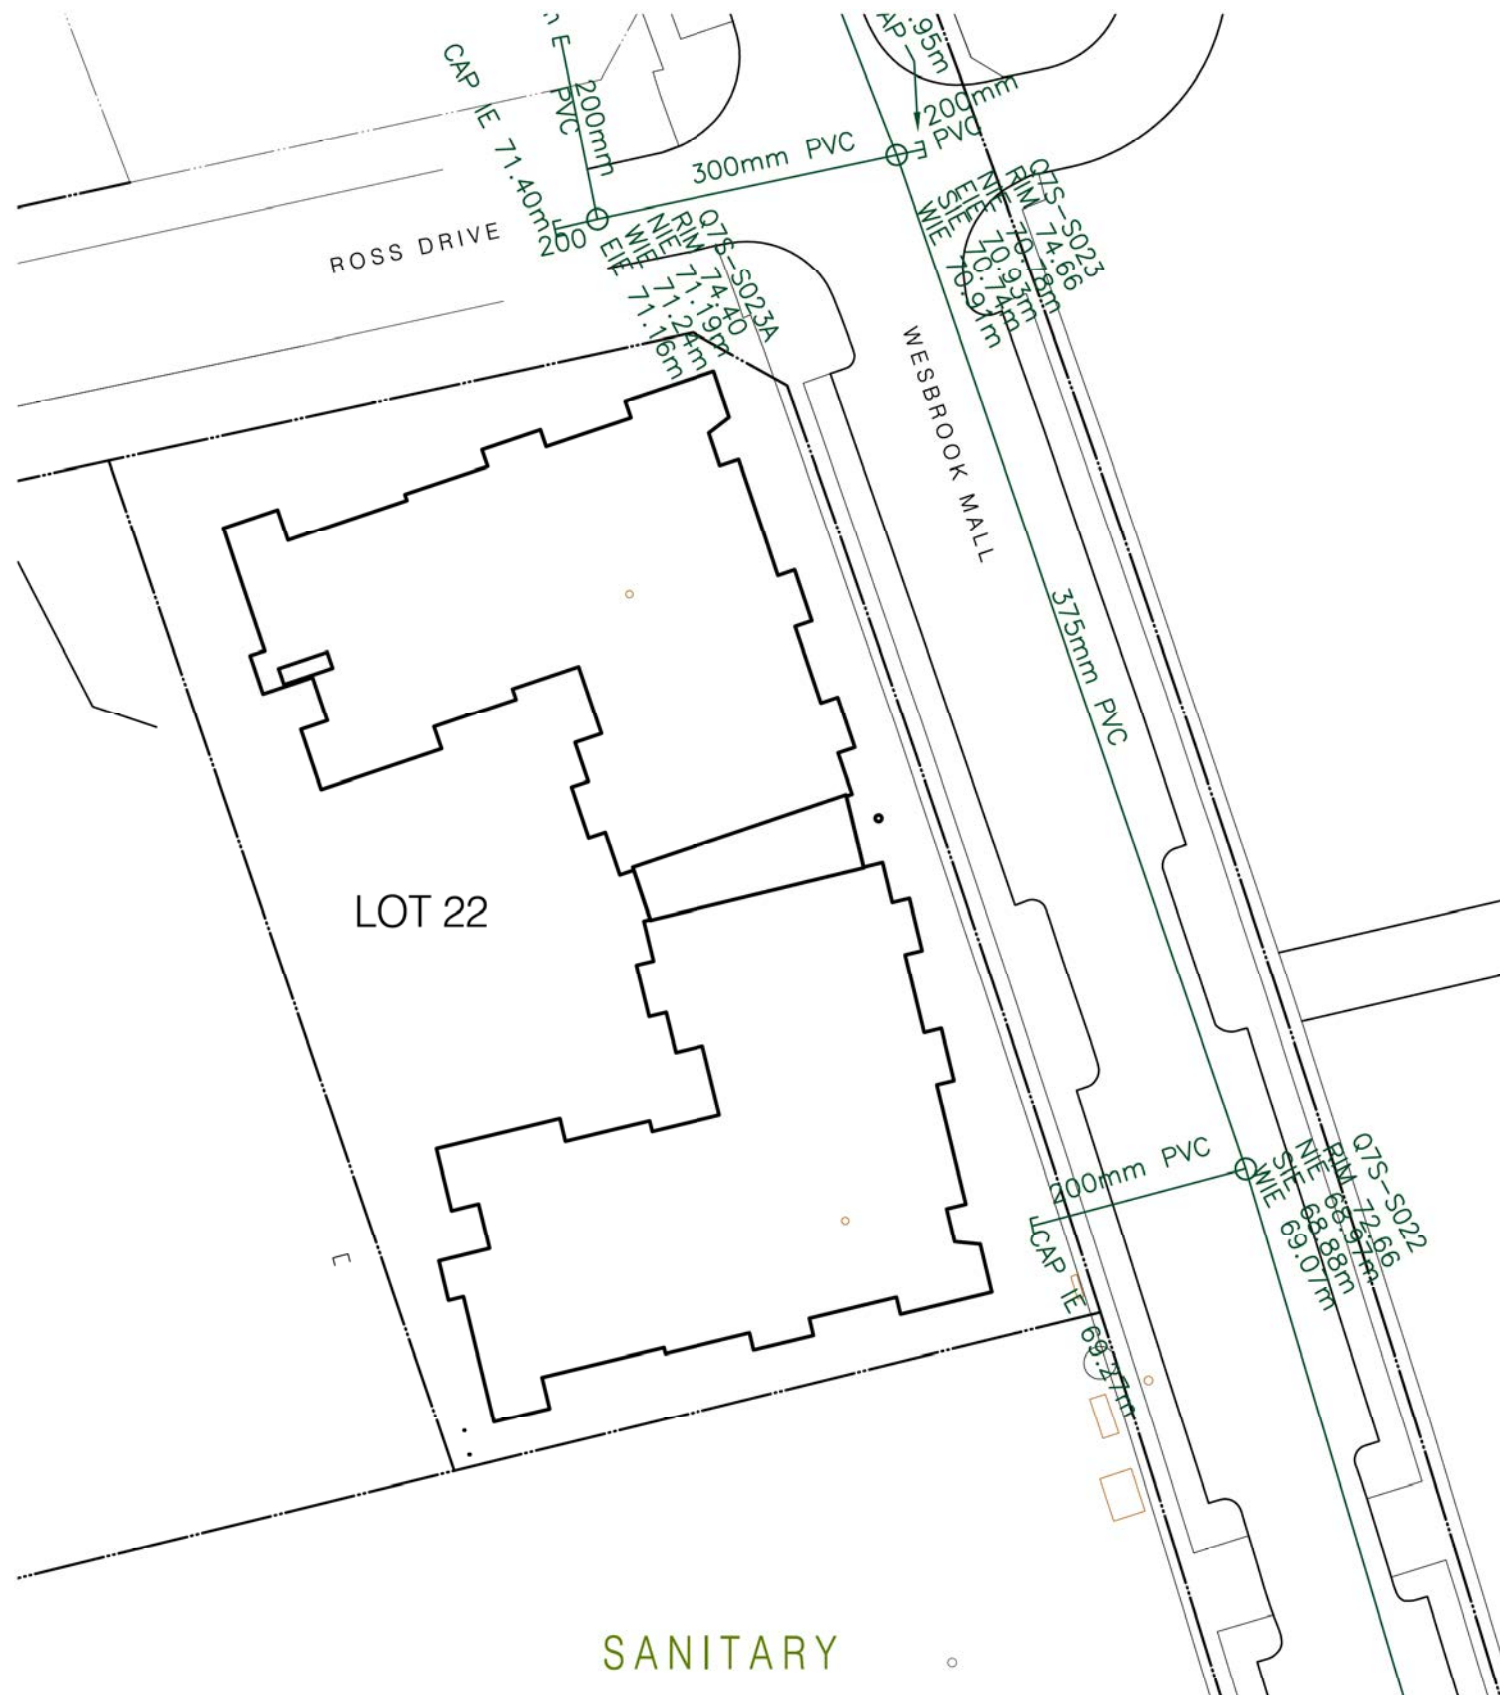

SANITARY

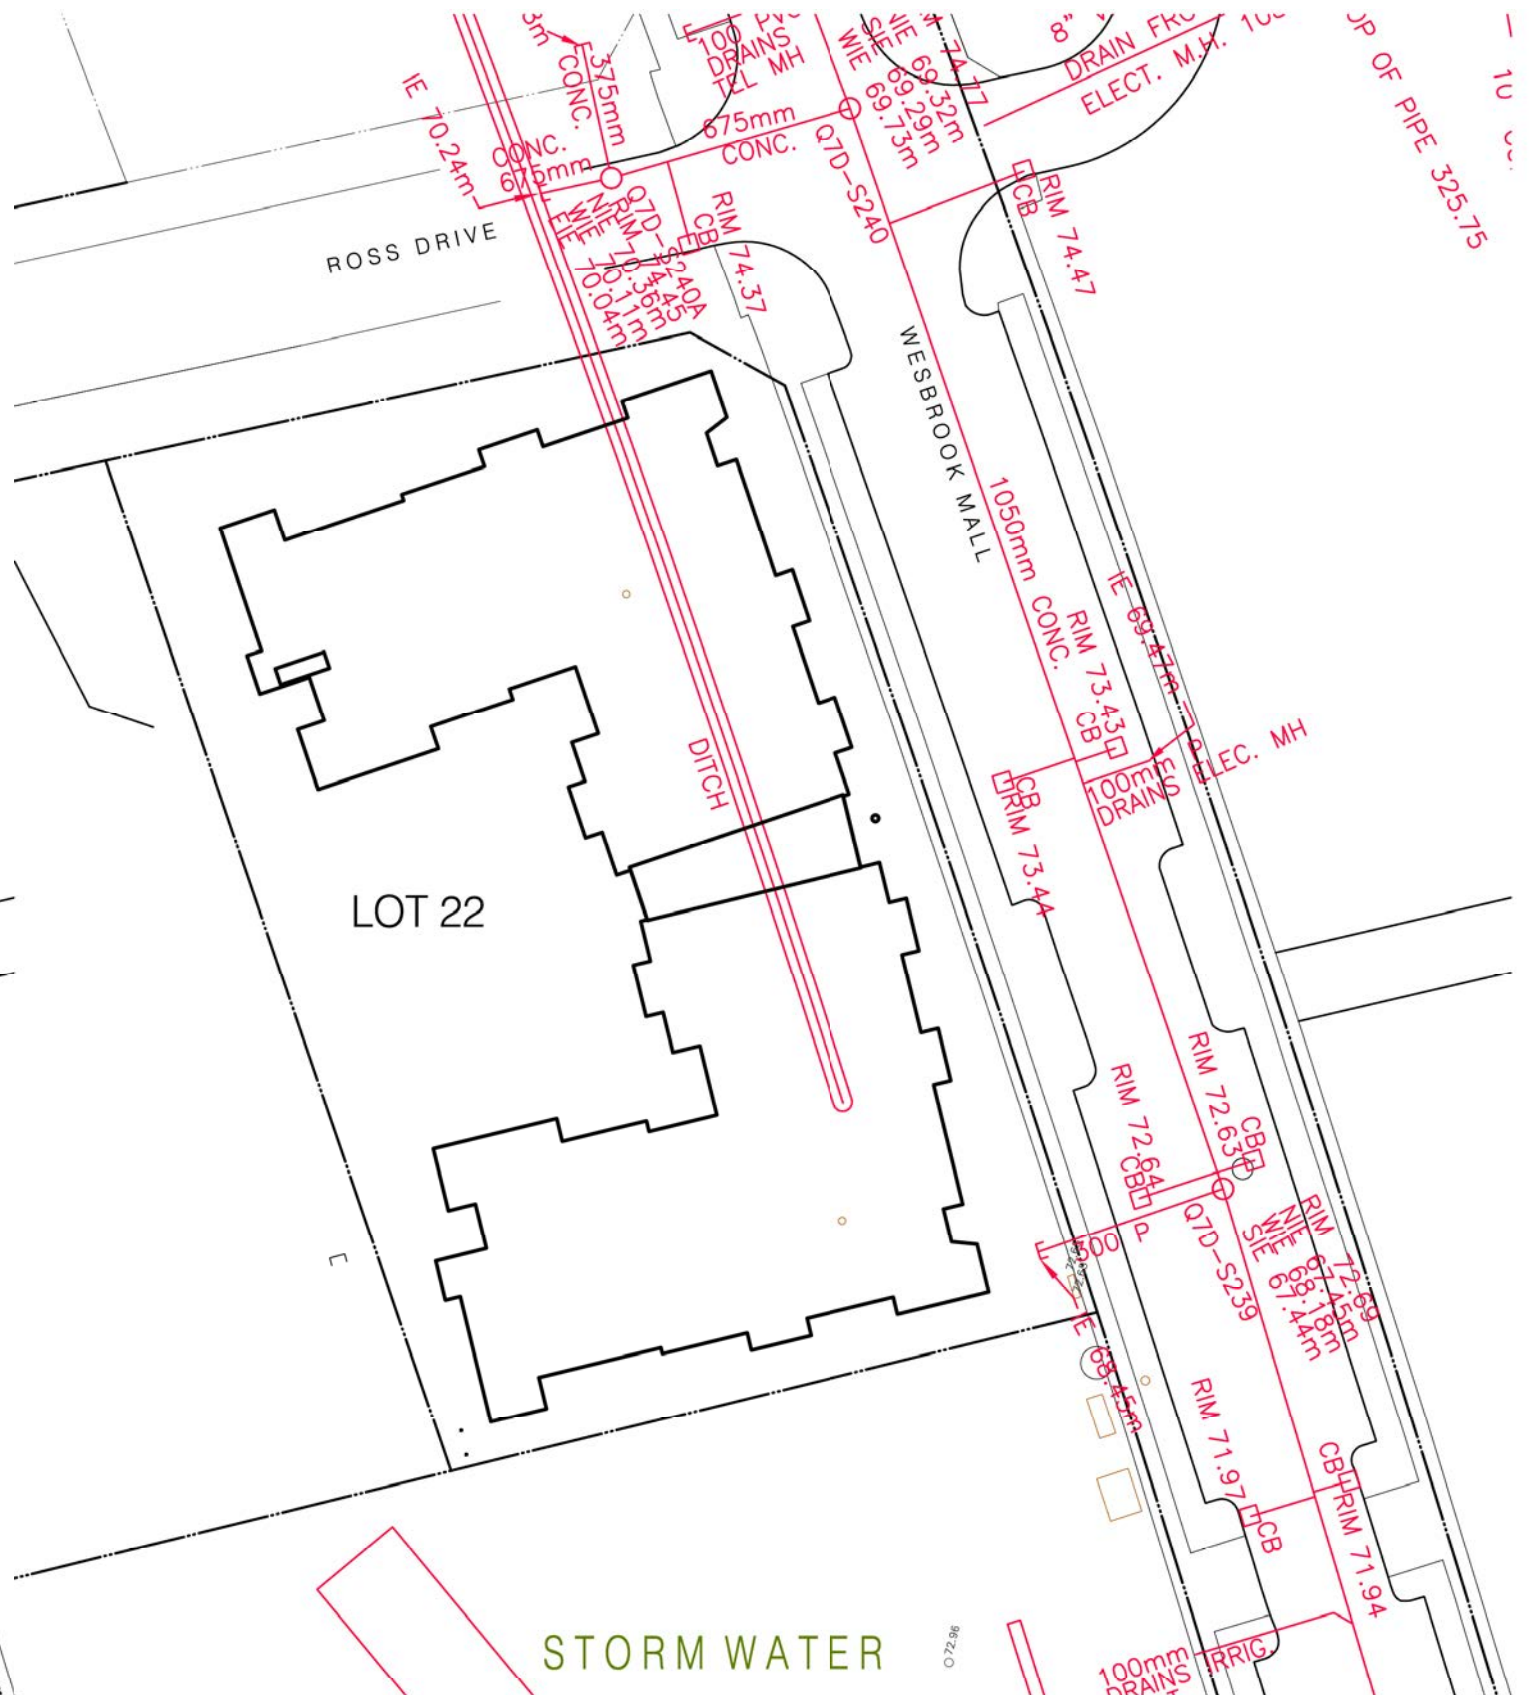

STORM WATER

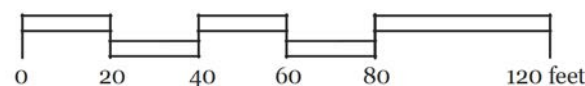


LOT 22 ~ UBC SOUTH CAMPUS UTILITIES RECORD PLANS


Jan 4, 2013 - Development Permit Submission Sk-9.03




UBC Properties Trust

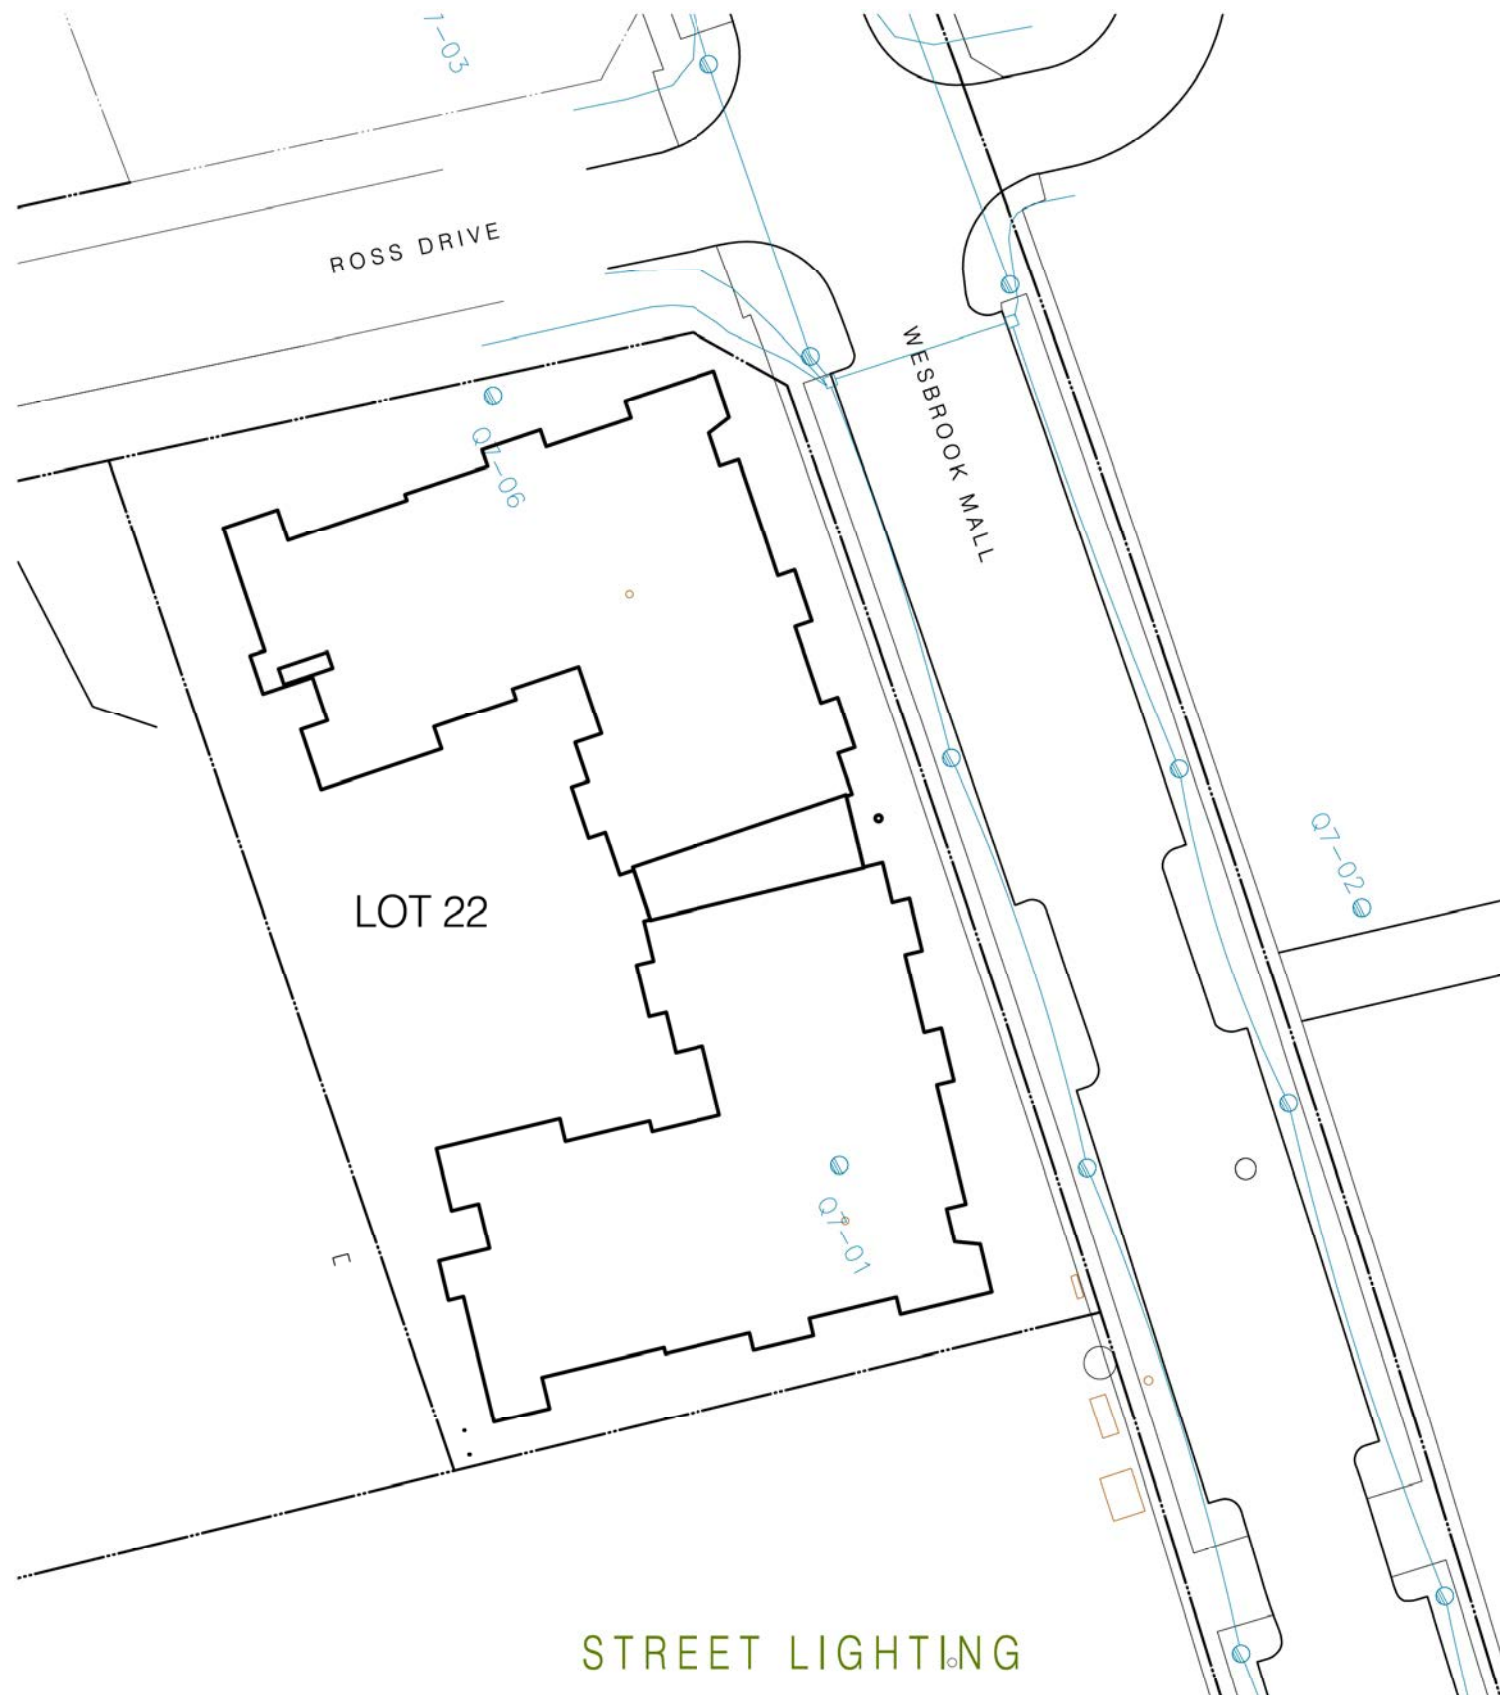

STREET LIGHTING

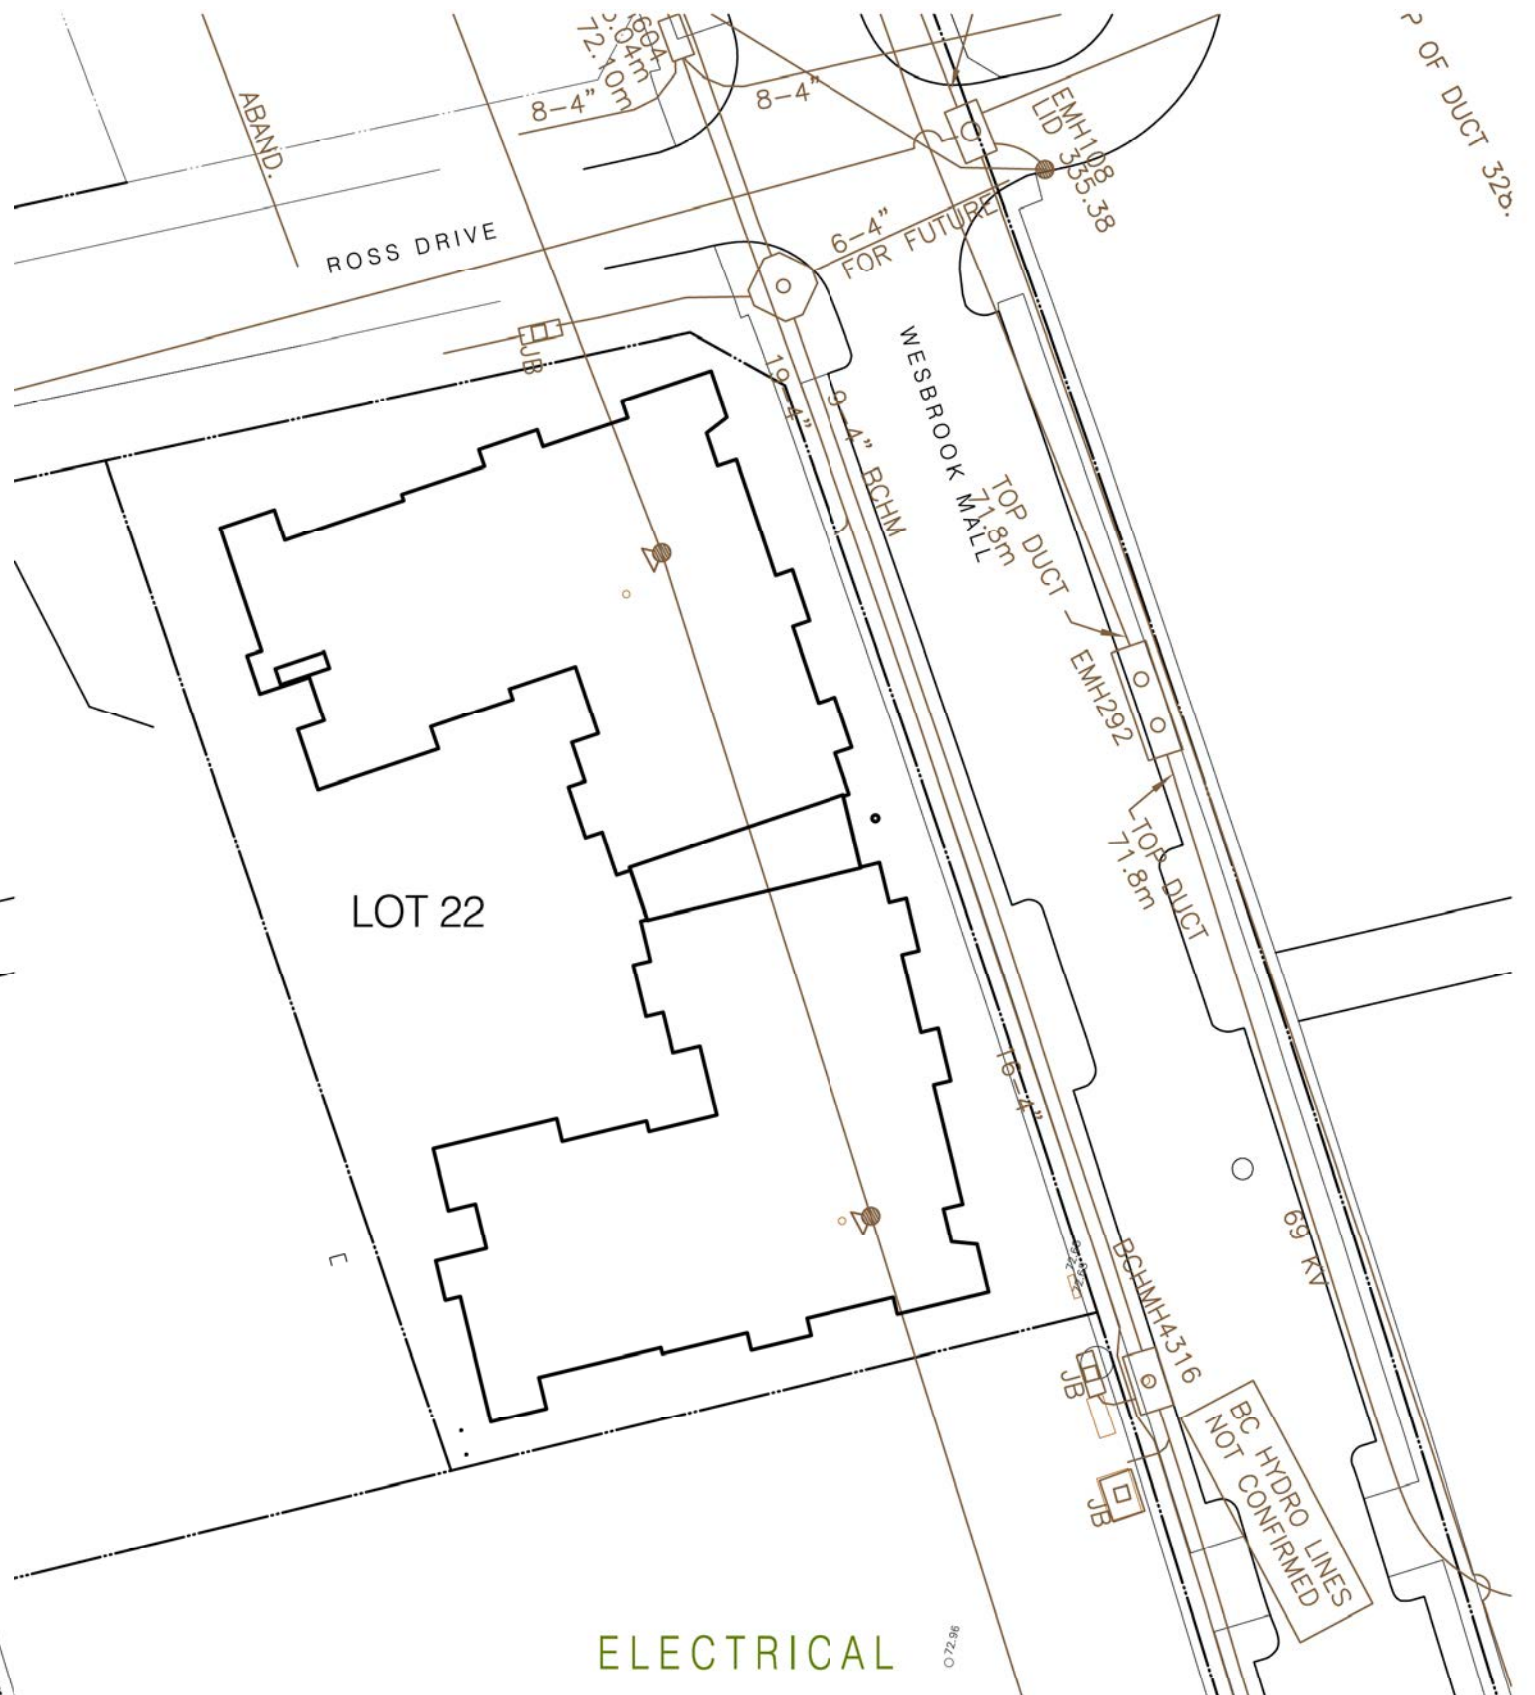

ELECTRICAL

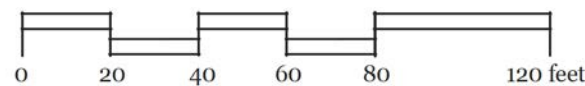



LOT 22 ~ UBC SOUTH CAMPUS UTILITIES RECORD PLANS

Jan 4, 2013 - Development Permit Submission Sk-9.04



UBC Properties Trust

SKETCH SHOWING
TOPOGRAPHIC SURVEY OF
LOT 22, DISTRICT LOT 6494, GROUP 1,
NEW WESTMINSTER DISTRICT, PLAN BCP30252
UNIVERSITY OF BRITISH COLUMBIA
SOUTH CAMPUS

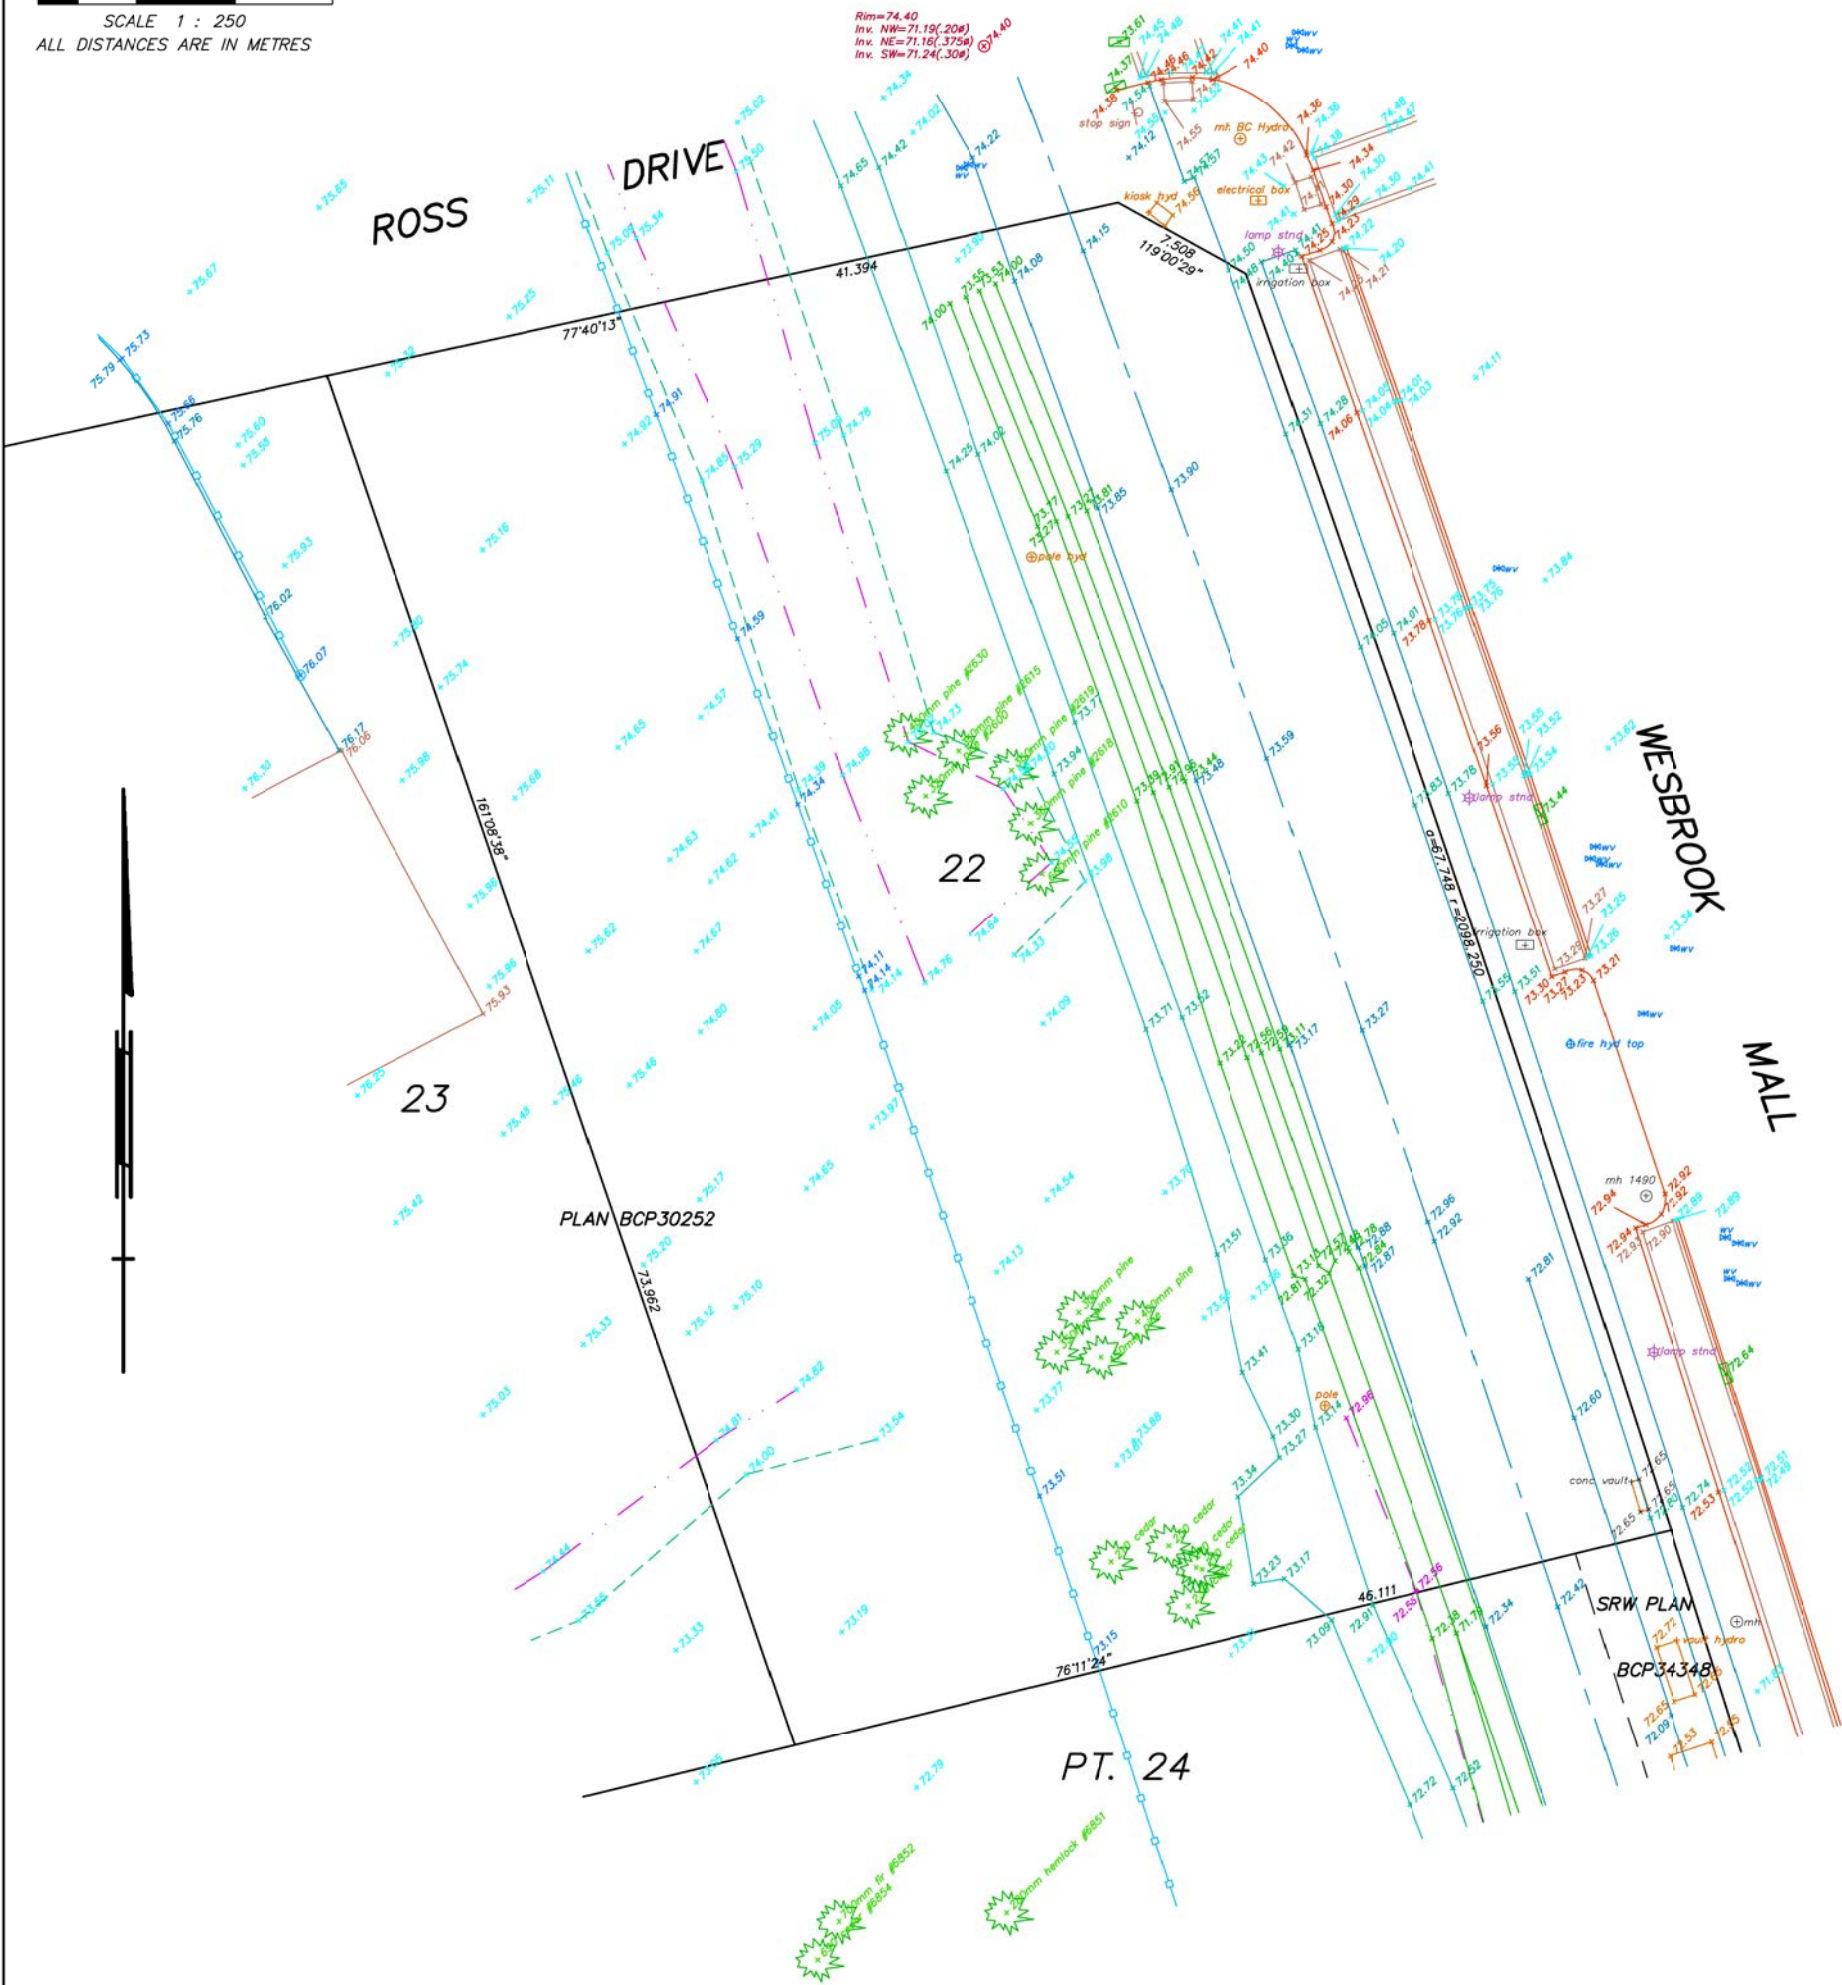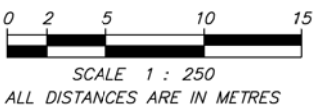

MURRAY & ASSOCIATES
201-12448 82nd AVENUE
SURREY, B.C.
V3W 3E9
(604) 597-9189

NOTES :
All elevations and distances shown are in metres.
Elevations are derived from UBC Monument W-W, located
on East Mall in front of the CEME Building (between
Agronomy Road and University Boulevard)
Geodetic Elevation = 93.631

CONTACT
Gregory Marston, B.C.L.S.
(604) 572-5423
gmarston@murrayls.com

CERTIFIED CORRECT DATED THIS
20th DAY OF MAY, 2008.

B. C. L. S.

FILE 8613CA-125